




**SECTION "A"**  
SCALE: 1/4" = 1'-0"

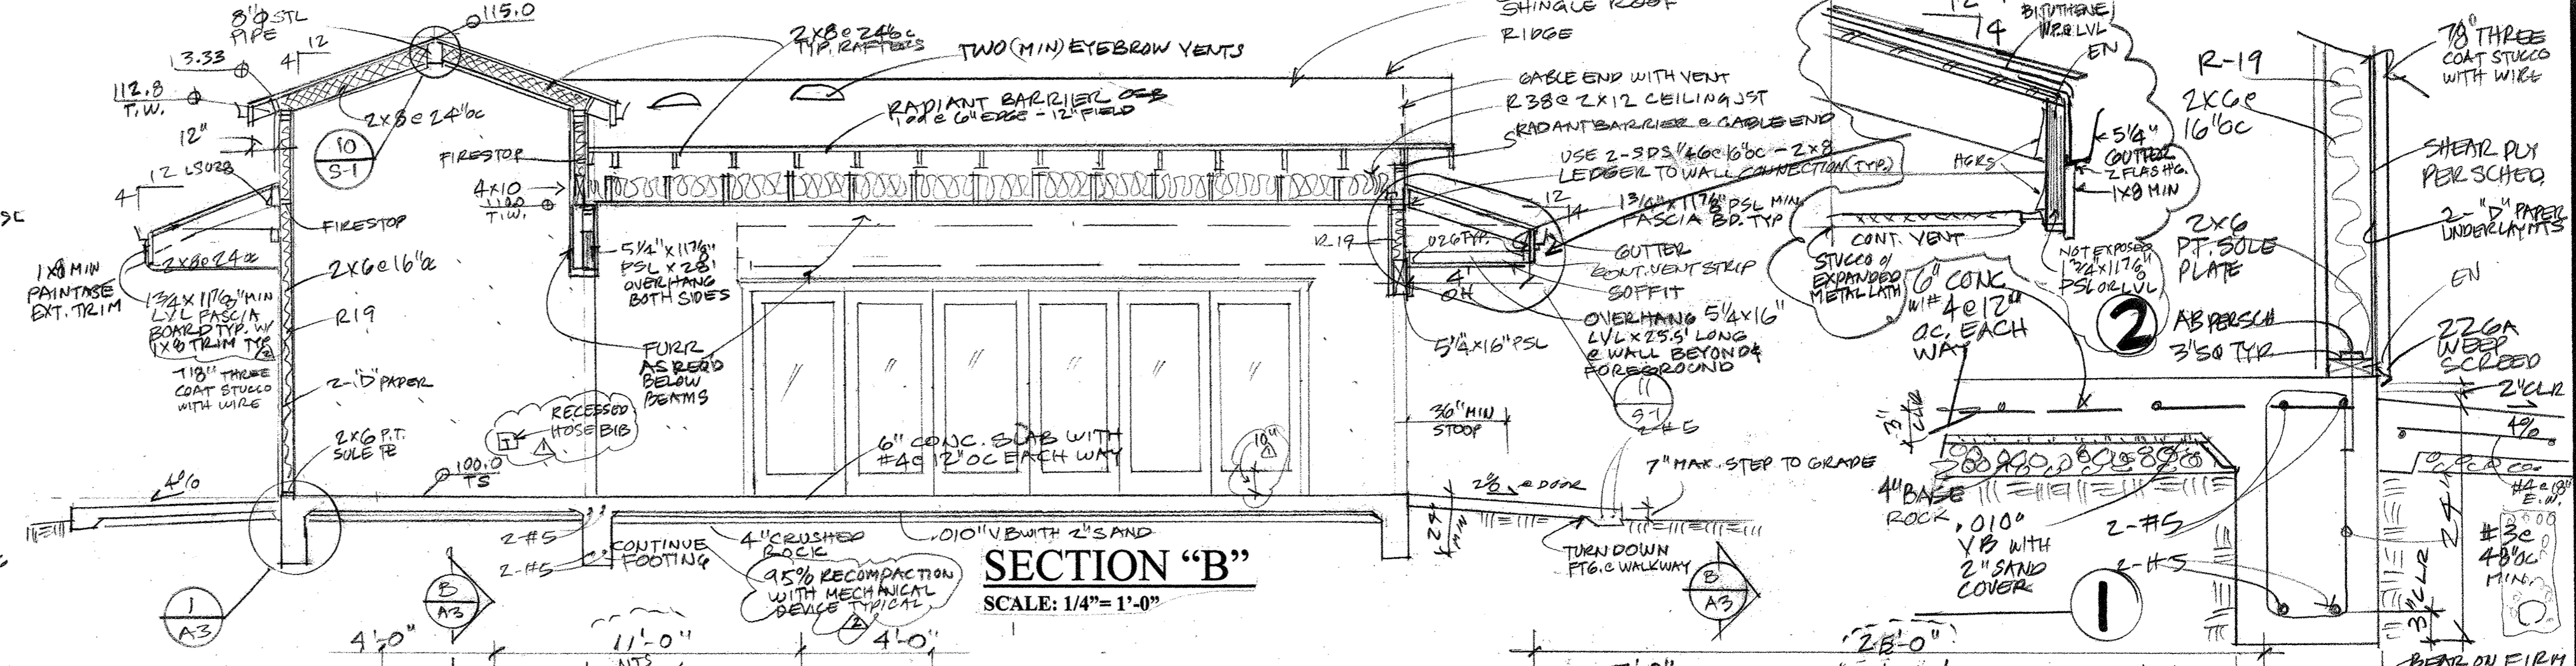


**SECTION "B"**  
SCALE: 1/4" = 1'-0"

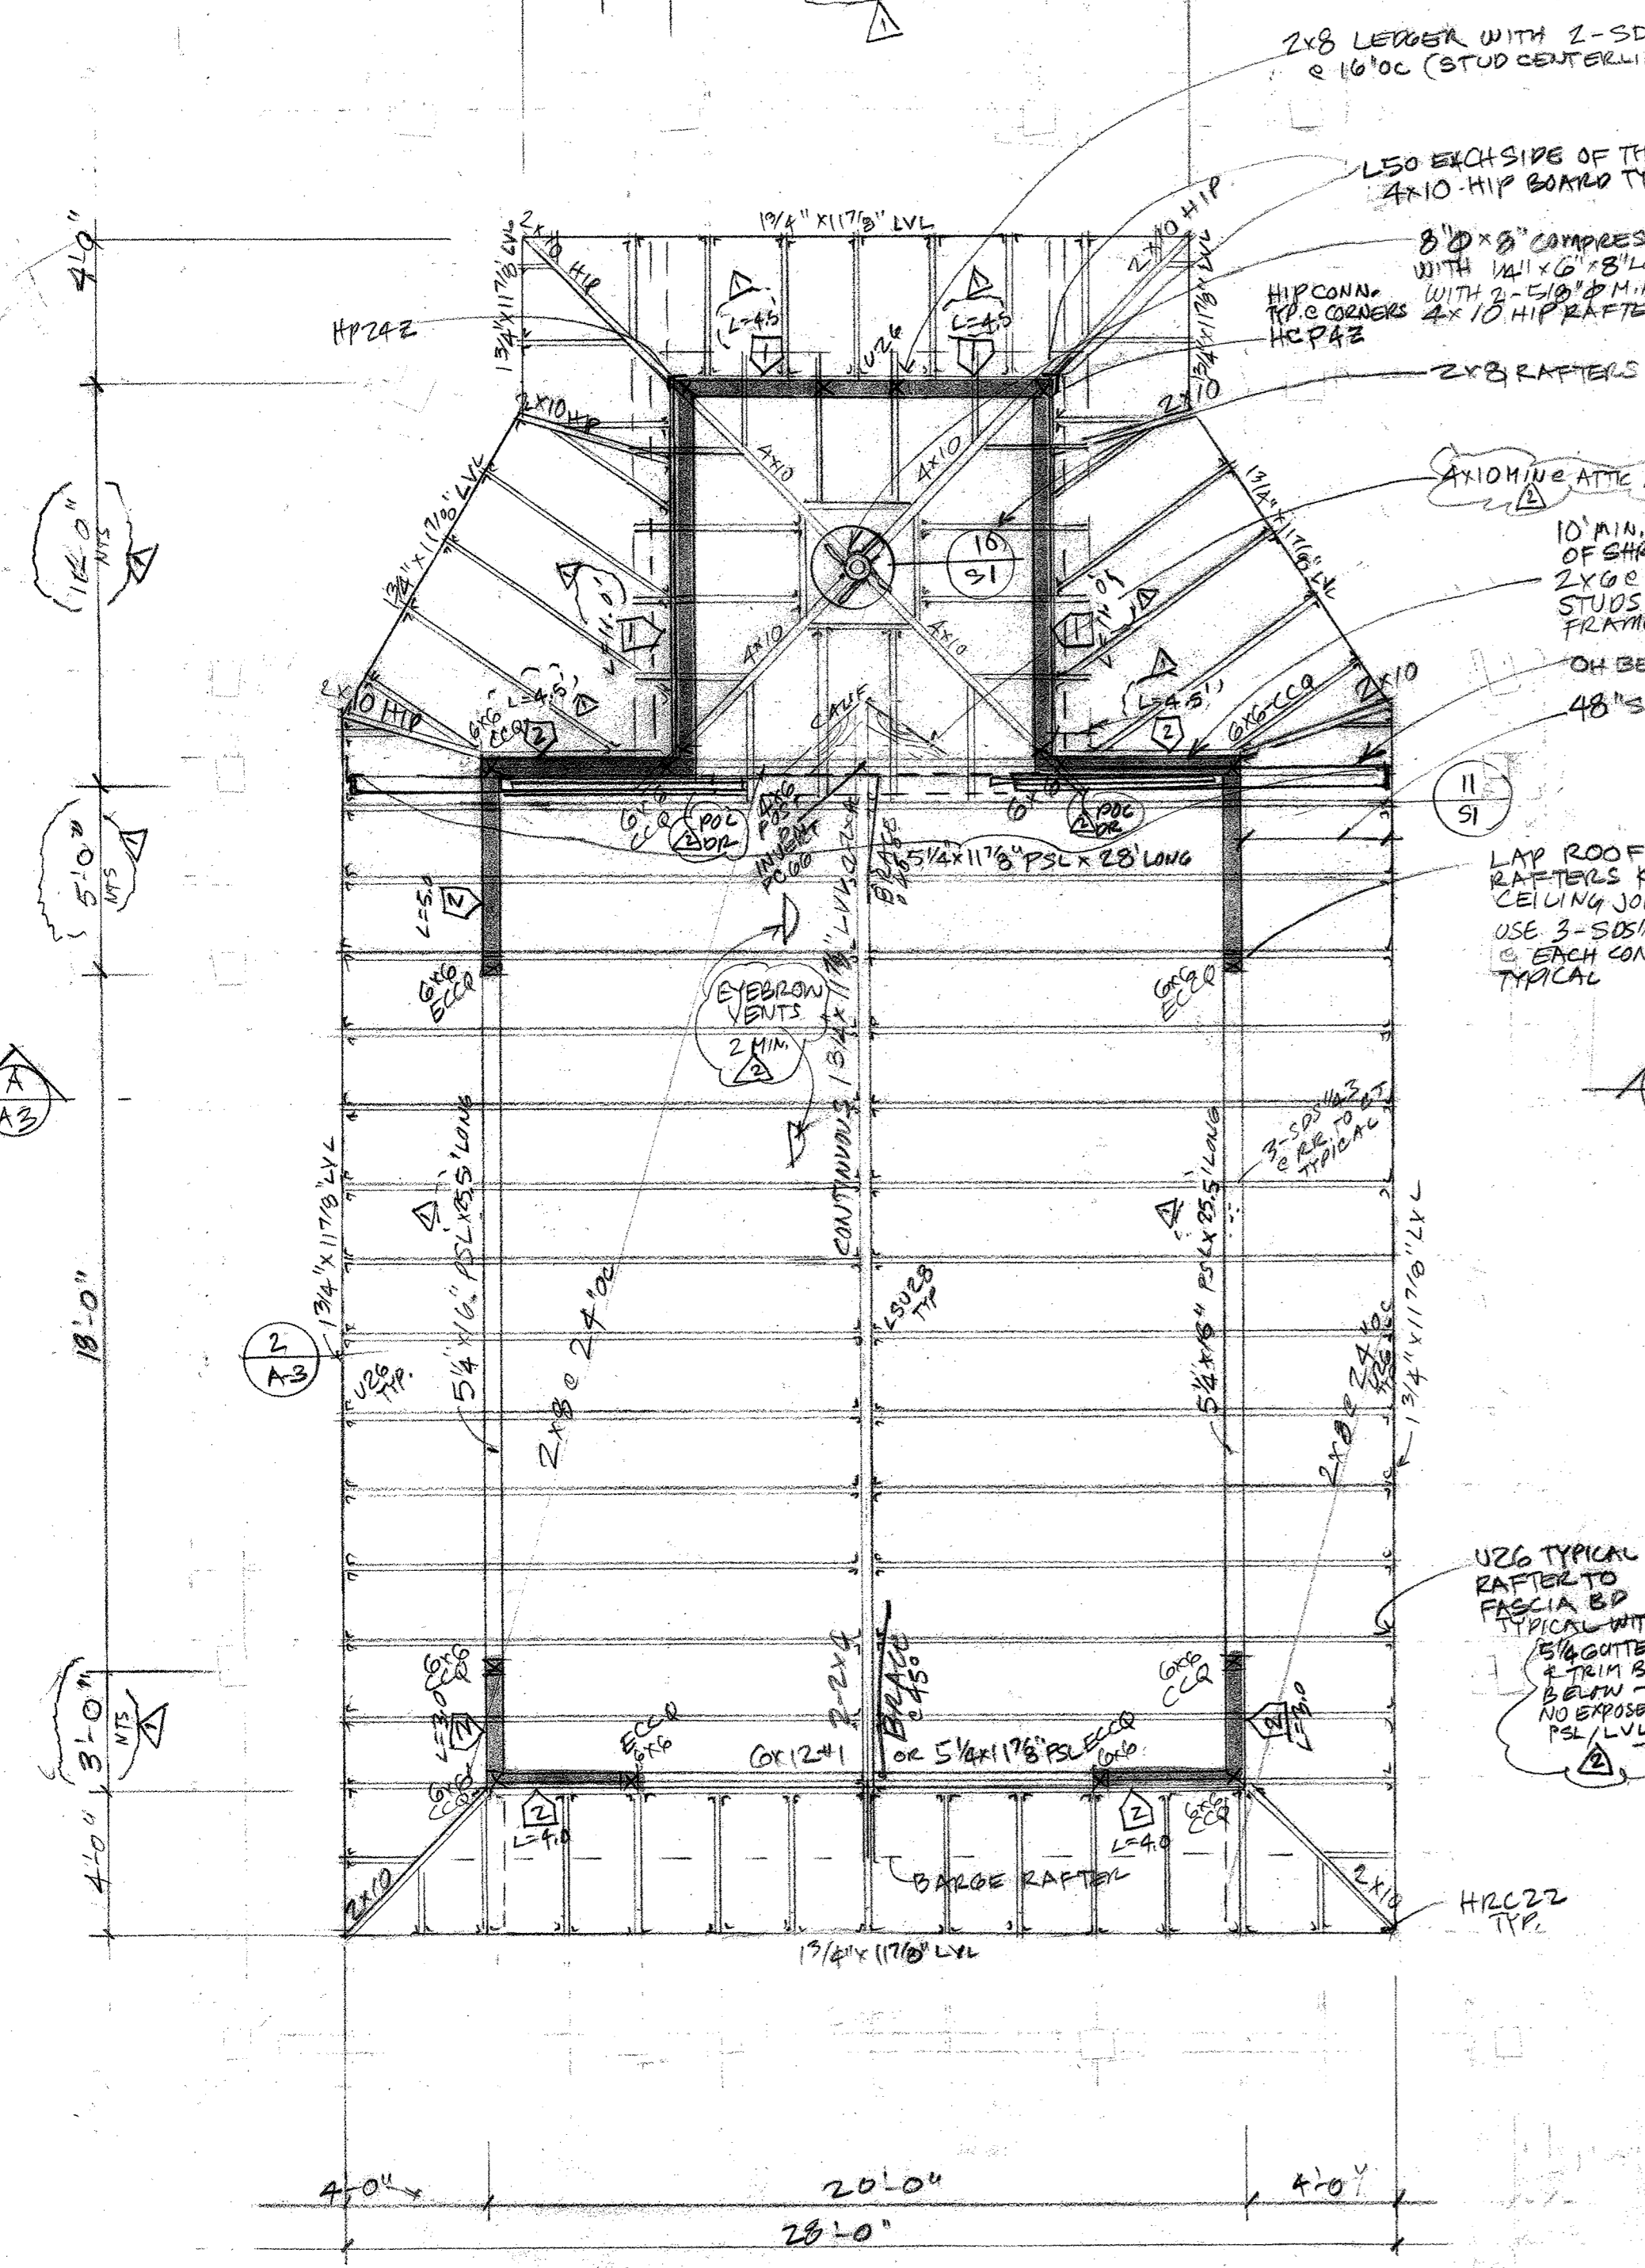

**ROOF FRAMING PLAN**  
SCALE: 1/2" = 1'-0"

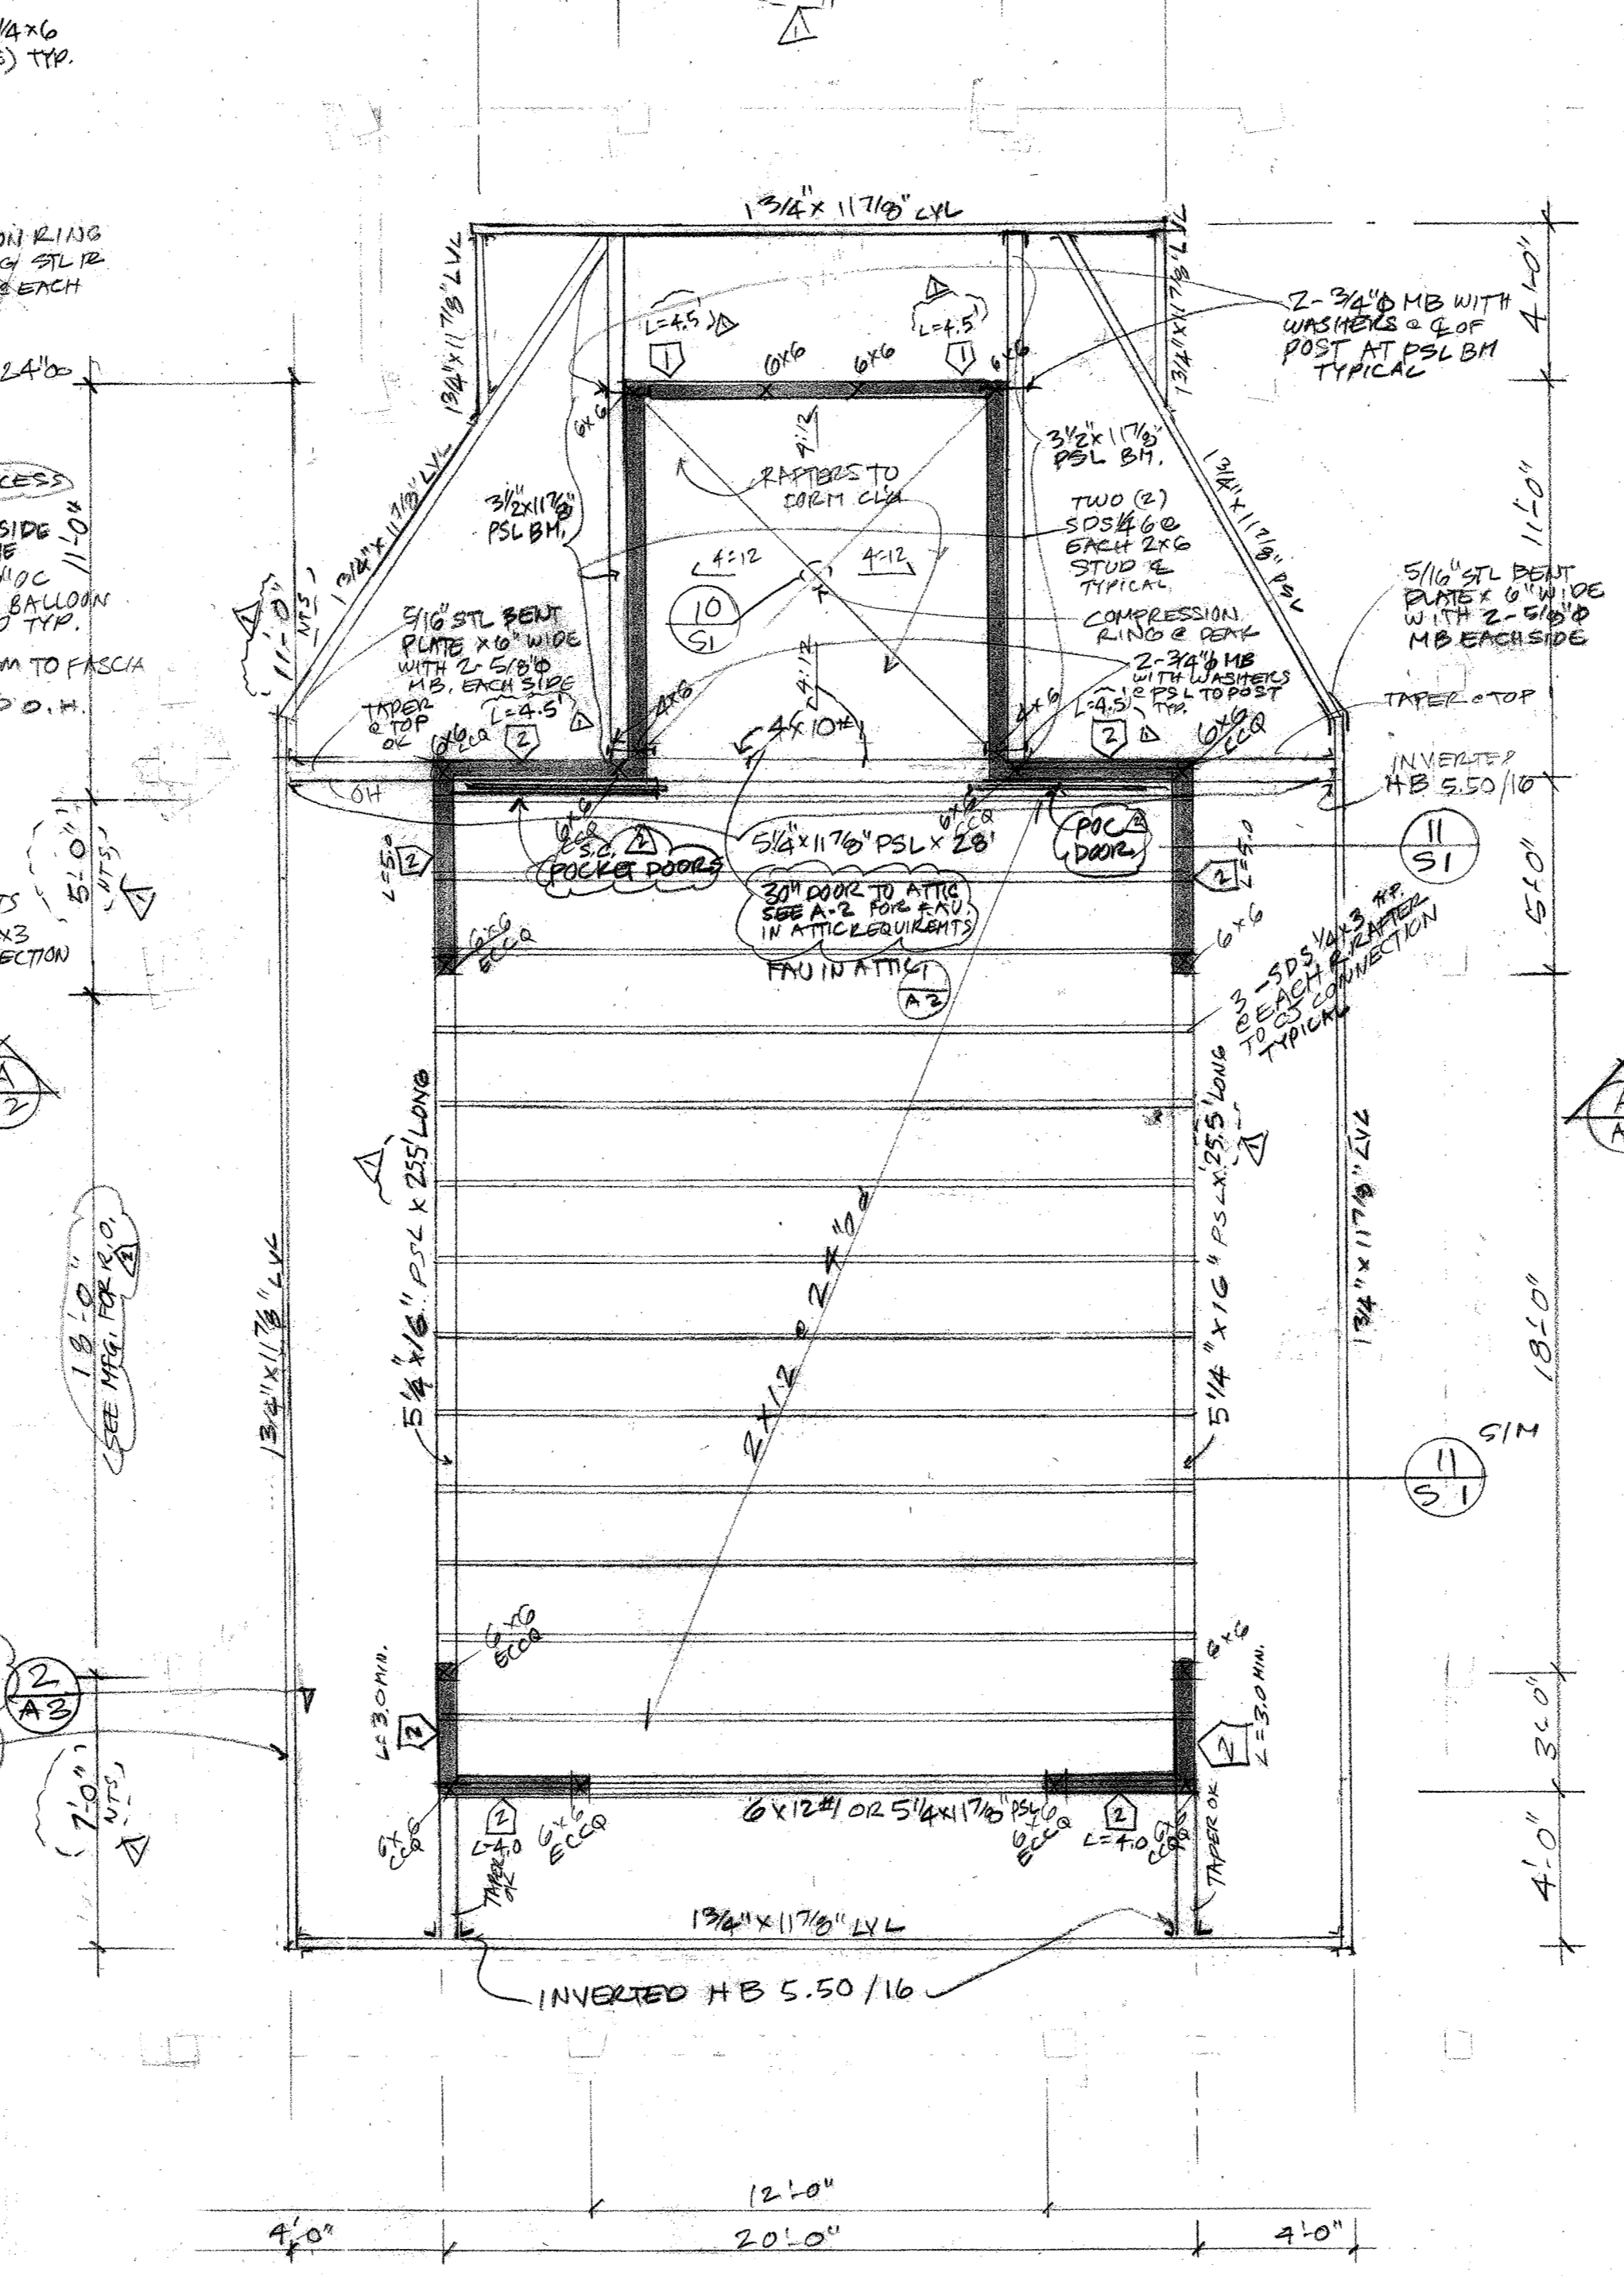

**CEILING FRAMING PLAN**  
SCALE: 1/2" = 1'-0"

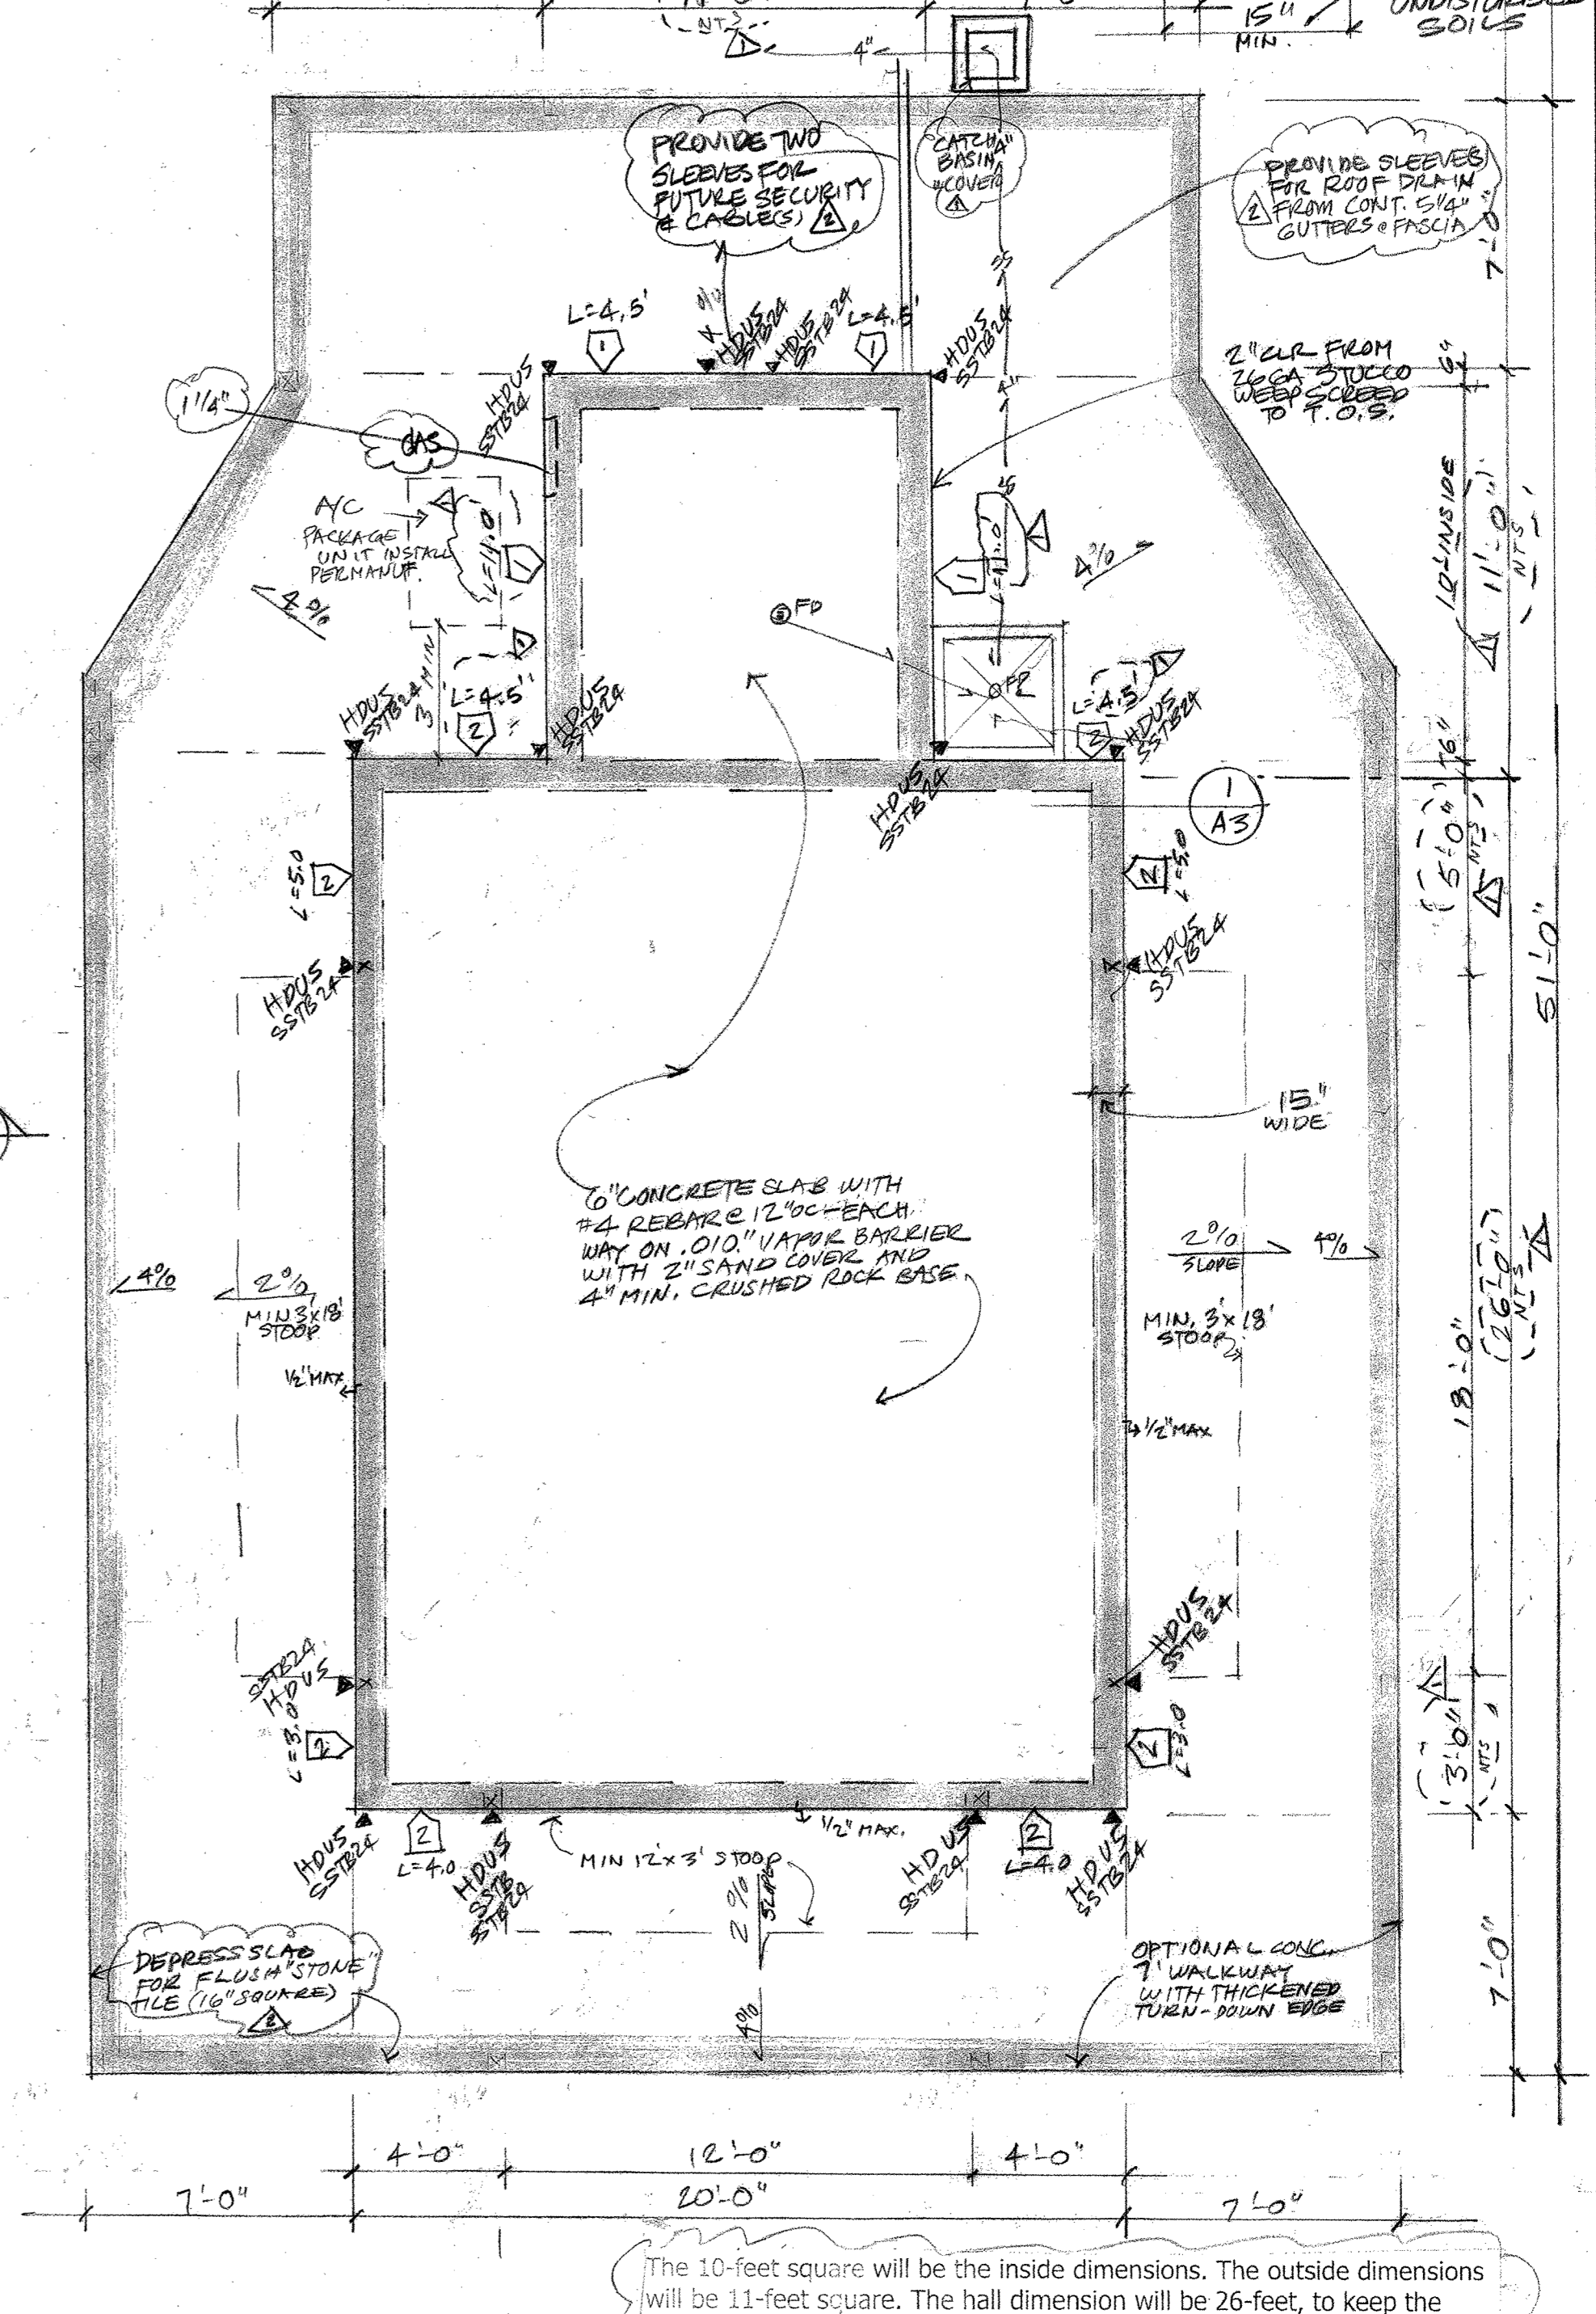

**FOUNDATION PLAN**  
SCALE: 1/2" = 1'-0"

The 10-foot square will be the inside dimensions. The outside dimensions will be 11-foot square. The hall dimension will be 26-feet, to keep the total area the same. As-built drawings will reflect this change.

REV. DIM 1/11/11

RECHARD LOUISBURY  
DRAFTSMAN  
1995 330 9510  
11000 11000  
LIVERMORE, CA 94550 1751 447-9580

DRAWN BY

B. R. GOVINDARAO, S.E.  
Consulting Engineer  
State License Number: S3259  
864 Randall Way  
San Ramon, CA 94582  
925-833-9784

STRUC. ENG.

**HINDU COMMUNITY and CULTURAL CENTER**  
1232 ARROWHEAD AVE. LIVERMORE, CA 94551

OWNER

**ACCESSORY BUILDING**  
1395 HEATHER LANE  
LIVERMORE, CA 94551

PROJECT =

11-12-10  
1/2" = 1'-0"  
RL  
HEATHER

**A-3**